Date:

Monday, 3/24/2008 8:35:43 AM

User

Chantal Lavoie

**Process Sheet** 

Customer

: CU-DAR001 Dart Helicopters Services

**Estimate Number** 

S.O. No. :

Job Number : 10091

P.O. Number

This Issue : 3/24/2008 Prsht Rev.

: NC

First Issue : //

: 38066 **Previous Run** 

Written By

Checked & Approved By Comment

: Est: A 03.03.27

Type

: PURCHASED PARTS

New issue KJ/RF

**Drawing Revision** Material

**Due Date** 

**Drawing Name** 

Part Number

**Drawing Number** 

Project Number

: 3/26/2008

: BEARING

: D31835

: N/A

: C1

. D3183 REV. C1

Qty:

60 Um:

Each

**Additional Product** 

Job Number:



Seq. #:

1.0

**Machine Or Operation:** 

Description:

CX03103124 /

**PURCHASING** 

PG

Comment: PURCHASING Issue P/O: 5970

Bearing as per Dwg D3183

Single row, deep groove, Conrad type, shielded

Possible Supplier: NSK P/N 6800ZZ Certificate of conformity note is required

2.0

6800ZZ

Bearing



Comment: Qty.:

1.0000 Each(s)/Unit

Total:

60.0000 Each(s)

**BEARING** 

3.0 PACKAGING 1 PACKAGING RESOURCE #1



Comment: PACKAGING RESOURCE #1

Receive & Inspect For Transit Damage Ensure certificate of confomity is attached

4.0

QC6



Comment: DIMENSIONAL CHECK

5.0

PACKAGING 1

PACKAGING RESOURCE #1



Comment: PACKAGING RESOURCE #1

Identify and Stock Location:



### **Dart Aerospace Ltd**

DuitAu	. copace E	tu .							
W/O:		•	WC	RK ORDER CHANGES	3				
DATE	STEP	PR	OCEDURE CHAI	NGE	Ву	Date	Qty	Approval Chief Eng / Prod Mgr	Approval QC Inspector
Part No	:	PAR #:	Fault Categ	jory:	NCR: Yes	No <b>DQ</b>	<b>A</b> :	Date:	
					QA: N	C Close	d:	Date:	
NCR:			WORK ORDE	R NON-CONFORMAN	CE (NCR	)			
	T _	Description of NC		Corrective Action Section B	3	Verific	ration	Approval	Approval
DATE	STEP	Section A	Initial Chief Eng	Action Description Chief Eng	Sign & Date	Secti		Chief Eng	QC inspector

NOTE: Date & initial all entries

. Date:

Monday, 3/24/2008 8:35:43 AM

User:

Chantal Lavoie

**Process Sheet** 

Customer: CU-DAR001 Dart Helicopters Services

Drawing Name: BEARING

Part Number: D31835

Job Number: 38138

Job Number:



Seq. #:

**Machine Or Operation:** 

**Description:** 

6.0

FINAL INSPECTION/W/O RELEASE



Comment: FINAL INSPECTION/W/O RELEASE

Job Completion



U 08.03.27

## **Dart Aerospace Ltd**

W/O:		WORK ORDER CHANG	ES				
DATE	STEP	PROCEDURE CHANGE	Ву	Date	Qty	Approval Chief Eng / Prod Mgr	Approval QC Inspector
<del>,</del>							
					<u></u>		
Part No	:	PAR #: Fault Category:	_ NCR: Yes	No DQ	<b>A</b> :	Date: _	
			QA:	N/C Close	d:	Date: _	<del></del>
NCR:		WORK ORDER NON-CONFORMA	NCE (NC	R)			
		Corrective Action Section	on R			I .	1


NCR:			WORK ORDE	ER NON-CONFORMAN	CE (NCR)			
	STEP Description of NC Section A	Description of NC	Corrective Action Section B			Verification	Annroyal	Annroyal
DATE		Initial Chief Eng	Action Description Chief Eng	Sign & Date	Section C	Approval Chief Eng	Approval QC Inspector	

NOTE: Date & initial all entries






DESIGN	DRAWN E	DAKI AEKOSEA	DART AEROSPACE LTD HAWKESBURY, ONTARIO, CANADA			
CHECKE	D APPROVE	DRAWING NO. D3183	REV. C SHEET 1 OF 4			
DATE	04.02.17	BRACKET ASSEMBL	SCALE Y 1:1			
Α.	03.01.24	NEW ISSUE				

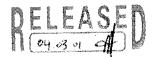


DATE		TITLE	SCALE
	04.02:17	BRACKET ASSEMBLY	1:1
Α.	03.01.24	NEW ISSUE	
В	03.06.17	REMOVE BEARING; 1.012 WS 0.882	
С	,04.02.17	ADD -045/-9; 0.182 WAS 0.431	

04.11.09 0-830 WAS 0-850

CI - 1 0 D3121-21 BOLT (1) D3183-045 BEARING ASSEMBLY (1)

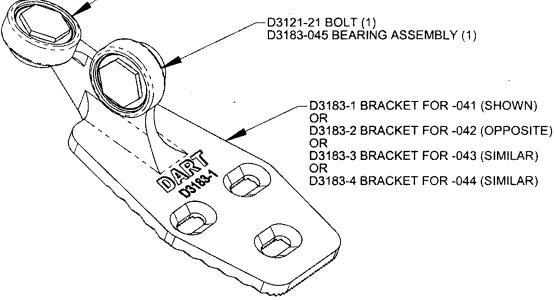


D3183-041 BRACKET ASSEMBLY (SHOWN)
D3183-042 BRACKET ASSEMBLY (OPPOSITE)
D3183-043 BRACKET ASSEMBLY (SIMILAR)
D3183-044 BRACKET ASSEMBLY (SIMILAR)

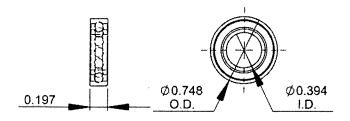

# D3183-5 BEARING: SPECIFICATION CONTROL DRAWING

- 1) SINGLE ROW, DEEP GROOVE, CONRAD TYPE, SHIELDED 2) POSSIBLE SUPPLIER: NSK P/N 6800ZZ
- 3) ALL DIMENSIONS ARE IN INCHES

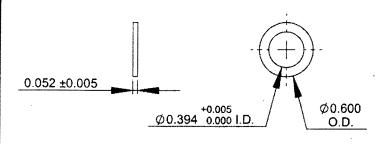


#### **D3183-7 WASHER**

- 1) MATERIAL: AISI 303 ROUND BAR (M303R) **ANNEALED**
- 2) BREAK ALL SHARP EDGES 0.005 TO 0.010
- 3) TOLERANCES ARE PER DART QSI 018
- **UNLESS OTHERWISE NOTED**
- 4) ALL DIMENSIONS ARE IN INCHES


#### COPYRIGHT © 2003 BY DART AEROSPACE LTD.

THIS DOCUMENT IS PRIVATE AND CONFIDENTIAL AND IS SUPPLIED ON THE EXPRESS CONDITION THAT IT IS NOT TO BE USED FOR ANY PURPOSE OR COPIED OR COMMUNICATED TO ANY OTHER PERSON WITHOUT WRITTEN PERMISSION FROM DART AEROSPACE LTD.

THIS DOCUMENT IS PRIVATE AND CONFIDENTIAL AND IS SUPPLIED ON THE EXPRESS CONDITION THAT IT IS NOT TO BE USED FOR ANY PURPOSE OR COPIED OR COMMUNICATED TO ANY OTHER PERSON WITHOUT WRITTEN PERMISSION FROM DART AEROSPACE LTD. (208103)= 138

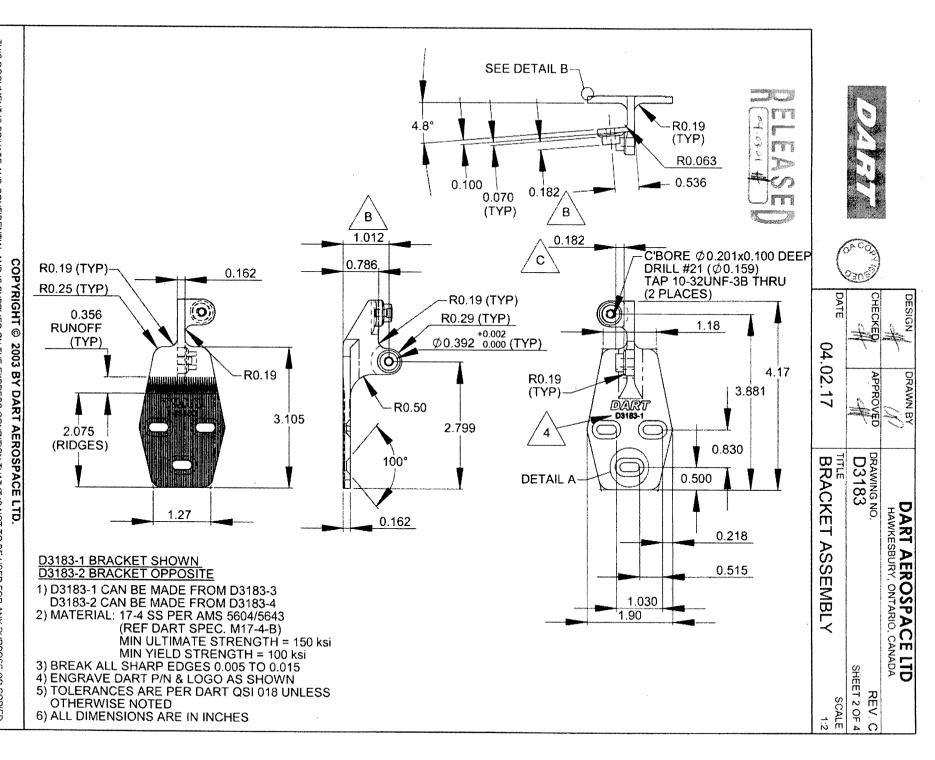


C\$08/03/24 W10: 38/38

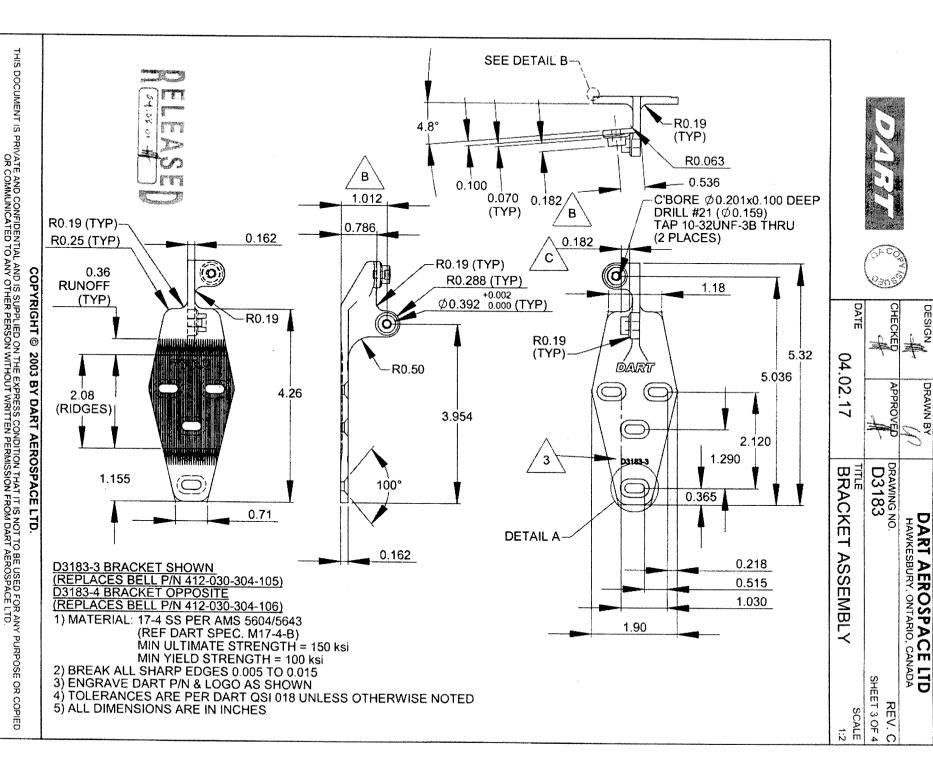





DESIGN DRAWN BY		DART AEROSPACE LTD HAWKESBURY, ONTARIO, CANADA				
CHECKED	APPROVED	DRAWING NO.	REV. C			
		D3183	SHEET 4 OF 4			
DATE		TITLE	SCALE			
	02 17	BDACKET ASSEMBLY	/ 1.1			

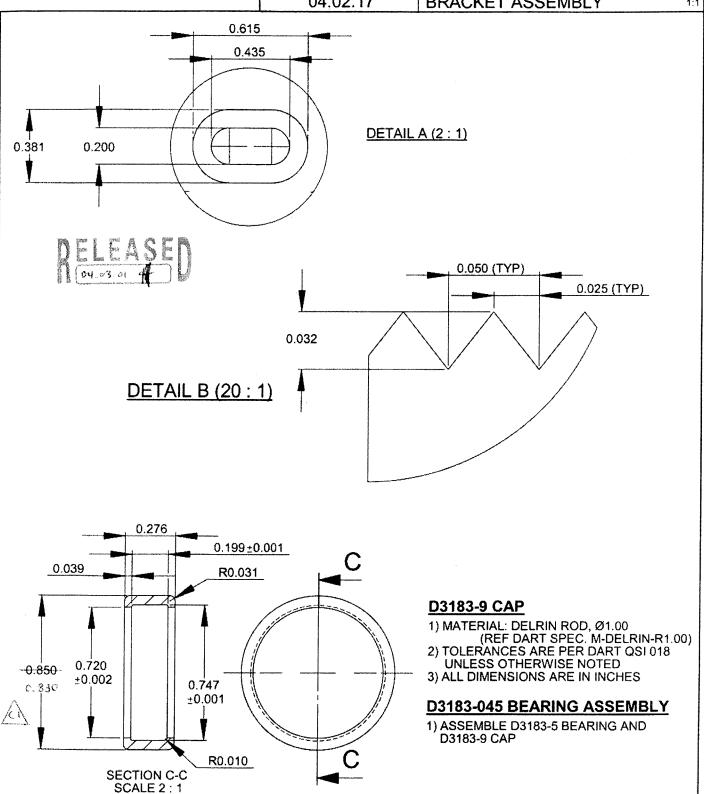

#### COPYRIGHT © 2003 BY DART AEROSPACE LTD.

THIS DOCUMENT IS PRIVATE AND CONFIDENTIAL AND IS SUPPLIED ON THE EXPRESS CONDITION THAT IT IS NOT TO BE USED FOR ANY PURPOSE OR COPIED OR COMMUNICATED TO ANY OTHER PERSON WITHOUT WRITTEN PERMISSION FROM DART AEROSPACE LTD.



GENERAL BEARING SERVIC

386 MAIN ST E. HAMESBURY, UNTARIO NÉA 188 (613) 632-9914

CALE MADE BY: DR. SHIP WIR: